


BASED UPON THE ORDNANCE SURVEY MAPPING WITH THE PERMISSION OF THE CONTROLLER OF HER MAJESTY'S STATIONERY OFFICE. © CROWN COPYRIGHT. UNAUTHORISED REPRODUCTION INFRINGES CROWN COPYRIGHT AND MAY LEAD TO PROSECUTION OR CIVIL PROCEEDINGS. City of York Council OS Licence No. 1000 2018

DS REPORT

Revision	By	Checked	Approved	Date	Description
A	LR			05/21	Speed cushions added to the north of zone
B	DF	LR		10/21	Priority narrowing design amended
C	LR			12/21	RSA amendments shown in red

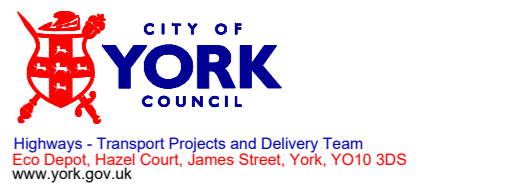

Project
CL-19-22 BURTON STONE LANE
WARD COMMITTEE
TRAFFIC CALMING FEASIBILITY STUDY

Drawing
GENERAL ARRANGEMENT
AMENDED DECEMBER 2021

Drawn by DF Date: OCT 2021
Checked by LR Date: OCT 2021
Authorised by - Date: -

Drawing No. TP/200007/100/01C GA Revision C
Drawing Scale: 1:500 A2
CAD Filename: Plot Scale: 1:00