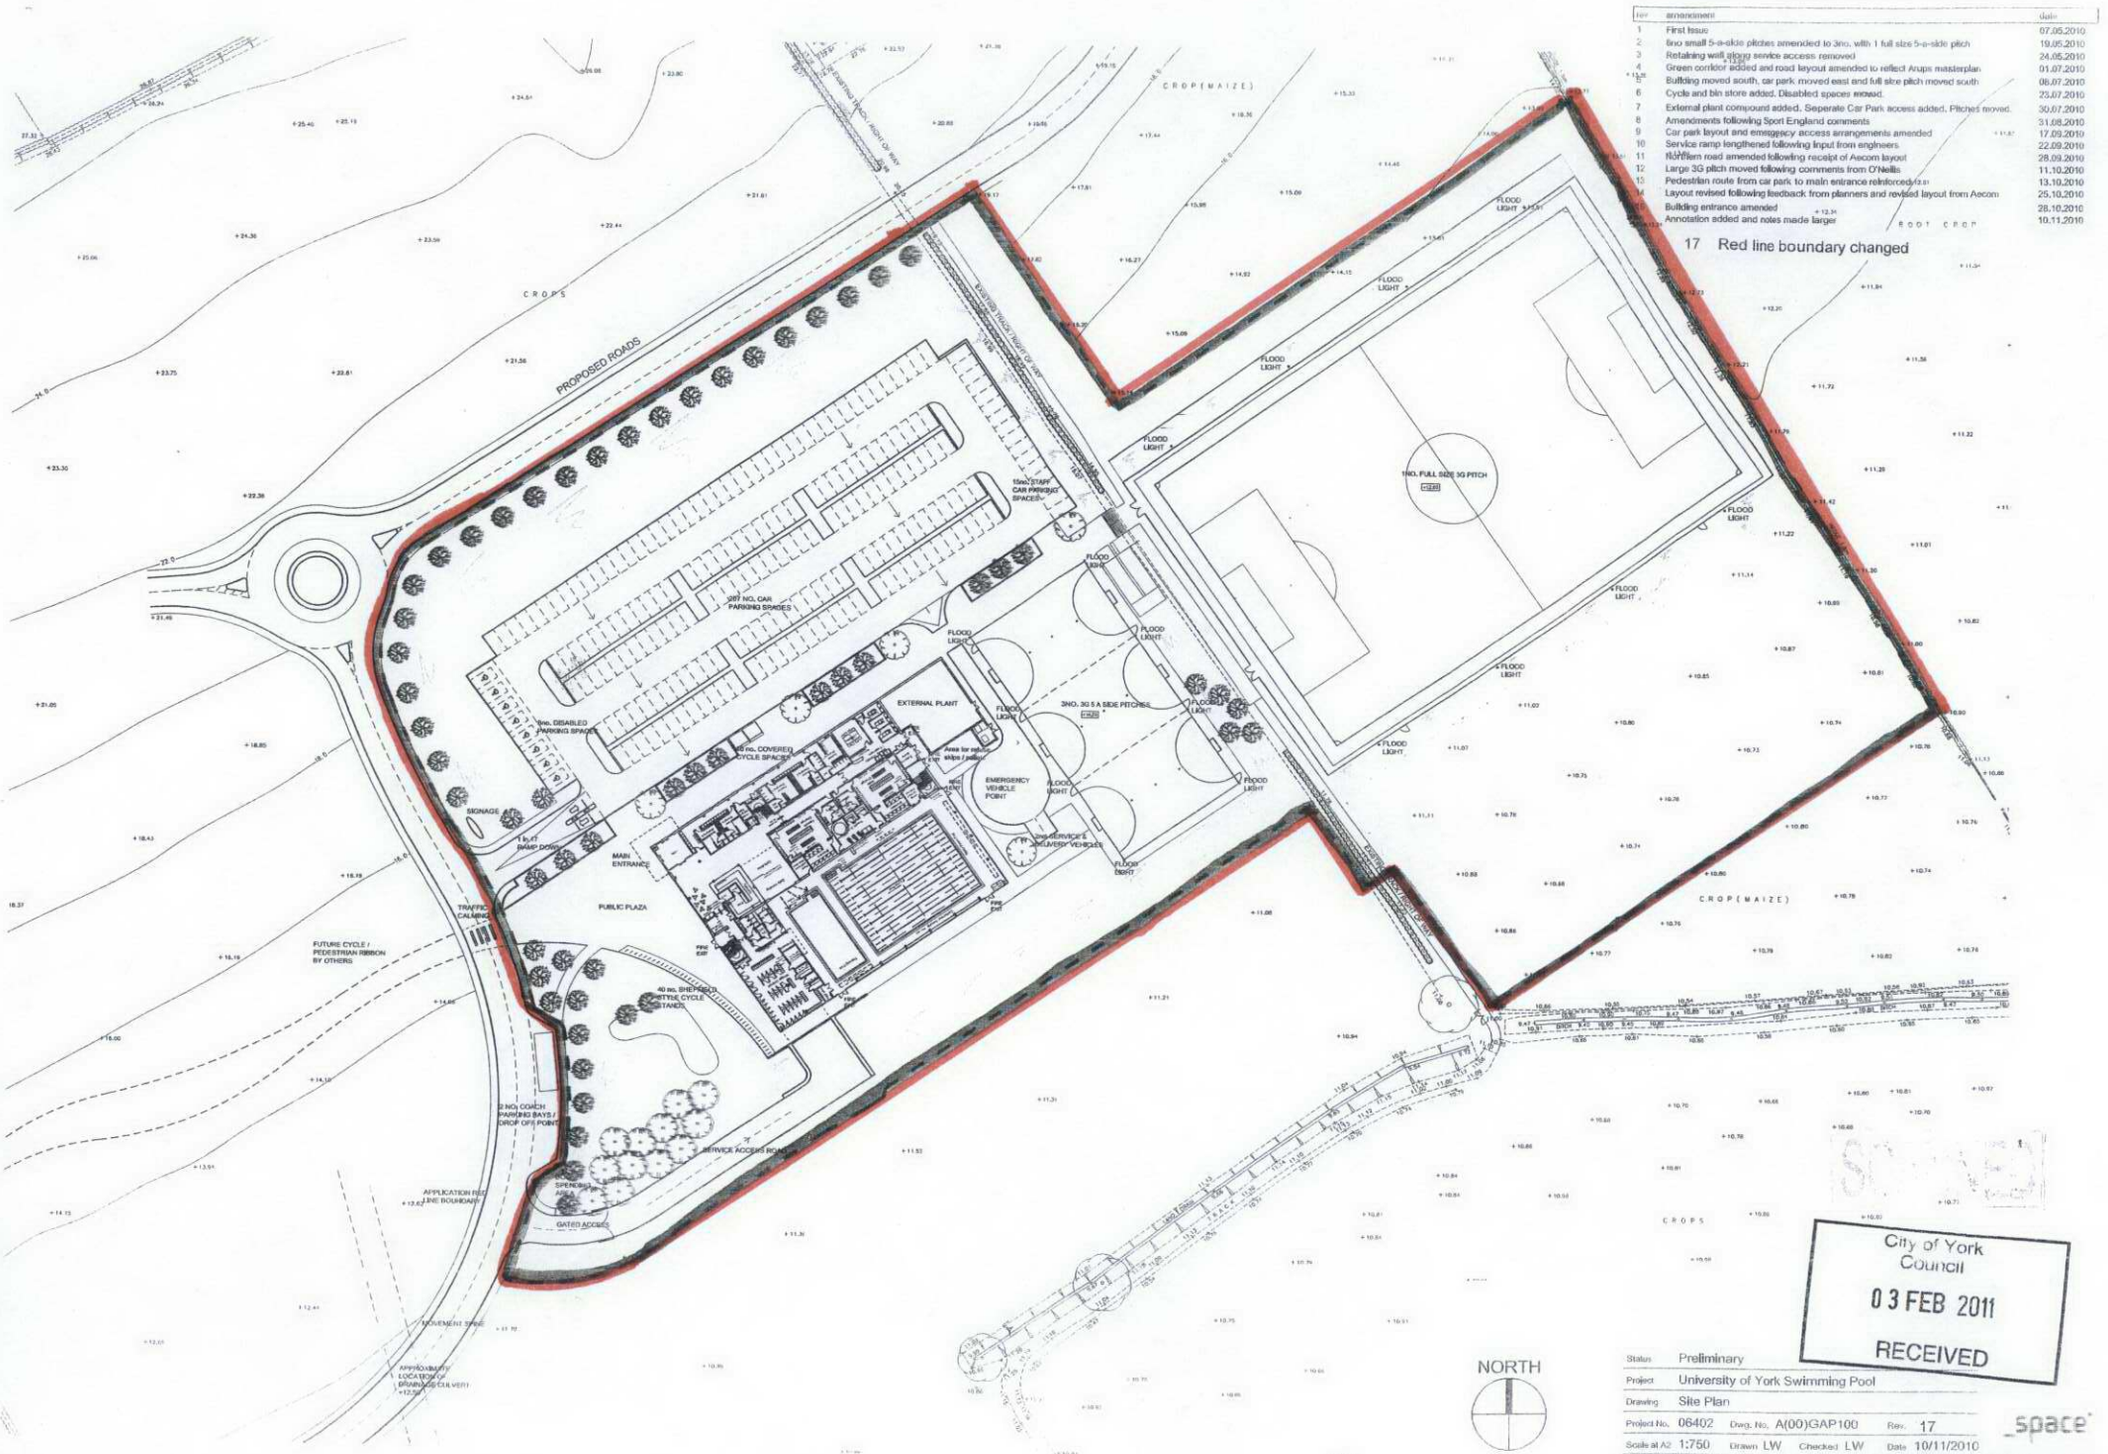

rev	amendment	date
1	First Issue	07.05.2010
2	6no small 5-a-side pitches amended to 3no. with 1 full size 5-a-side pitch	19.05.2010
3	Retaining wall along service access removed	24.05.2010
4	Green corridor added and road layout amended to reflect Arups masterplan	01.07.2010
5	Building moved south, car park moved east and full size pitch moved south	06.07.2010
6	Cycle and bin store added. Disabled spaces moved.	23.07.2010
7	External plant compound added. Seperate Car Park access added. Pitches moved.	30.07.2010
8	Amendments following Sport England comments	31.08.2010
9	Car park layout and emergency access arrangements amended	17.09.2010
10	Service ramp lengthened following input from engineers	22.09.2010
11	Northern road amended following receipt of Aecom layout	28.09.2010
12	Large 3G pitch moved following comments from O'Neills	11.10.2010
13	Pedestrian route from car park to main entrance reinforced	13.10.2010
14	Layout revised following feedback from planners and revised layout from Aecom	25.10.2010
15	Building entrance amended	28.10.2010
16	Annotation added and notes made larger	10.11.2010

17 Red line boundary changed

City of York Council
03 FEB 2011
RECEIVED

Status	Preliminary
Project	University of York Swimming Pool
Drawing	Site Plan
Project No.	06402
Dwg. No.	A(00)GAP100
Rev.	17
Scale at A2	1:750
Drawn	LW
Checked	LW
Date	10/11/2010

space

this drawing is copyright - check all dimensions on site - inform architect / no of any discrepancies - work to figured dimensions only - do not scale

10/2641/FULM